






PENK-RED .008 INCHES (1.5mm)  
 PENK-YELLOW .007 INCHES (1.8mm)  
 PENK-GREEN .010 INCHES (2.5mm)  
 PENK-ORANGE .014 INCHES (3.5mm)  
 PENK-BLUE .020 INCHES (5.0mm)  
 PENK-BROWN .027 INCHES (7.0mm)  
 PENK-WHITE .030 INCHES (10.0mm)

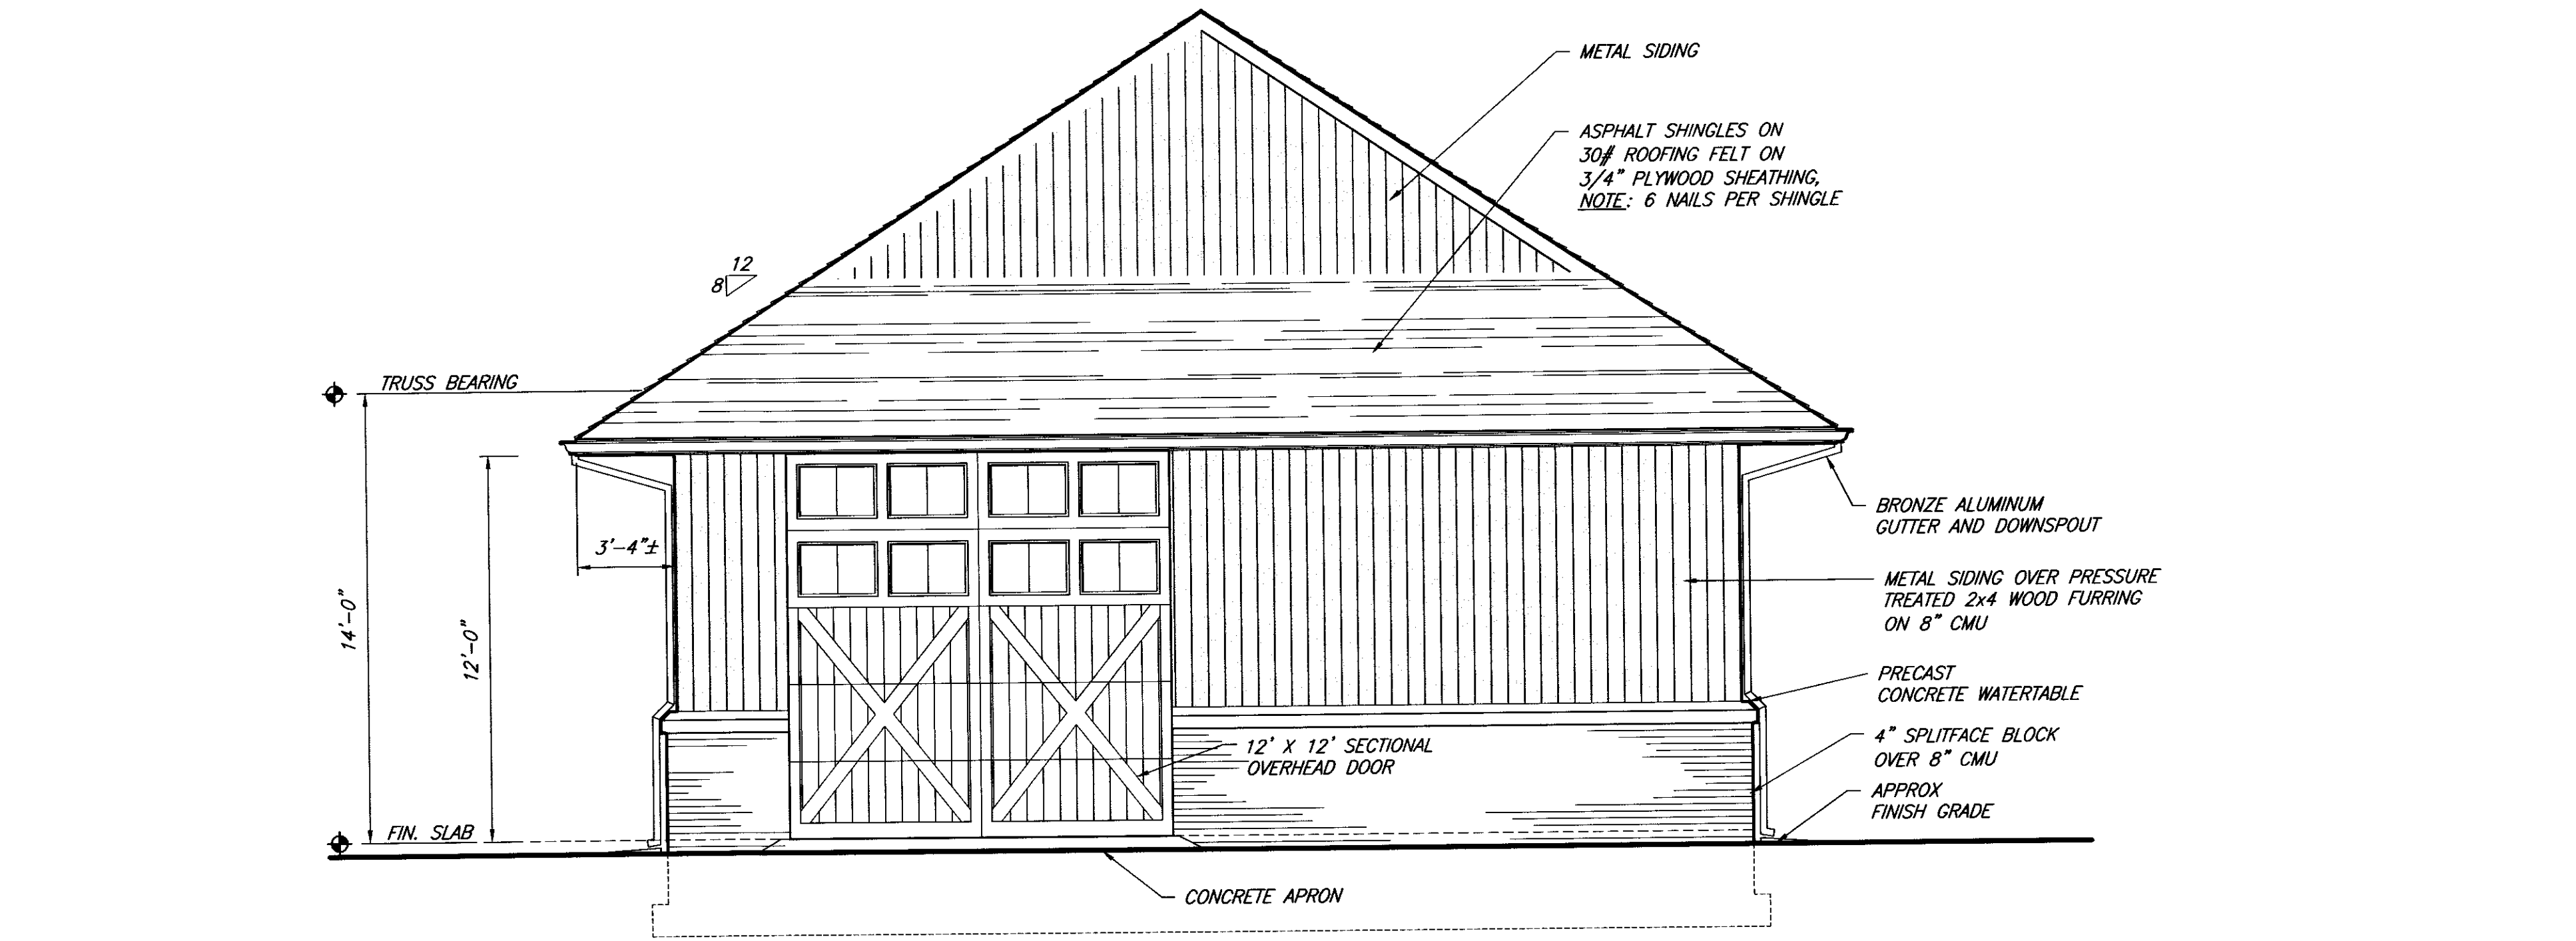

EAST ELEVATION (WEST ELEVATION SIM.)  
 1/4" = 1'-0"

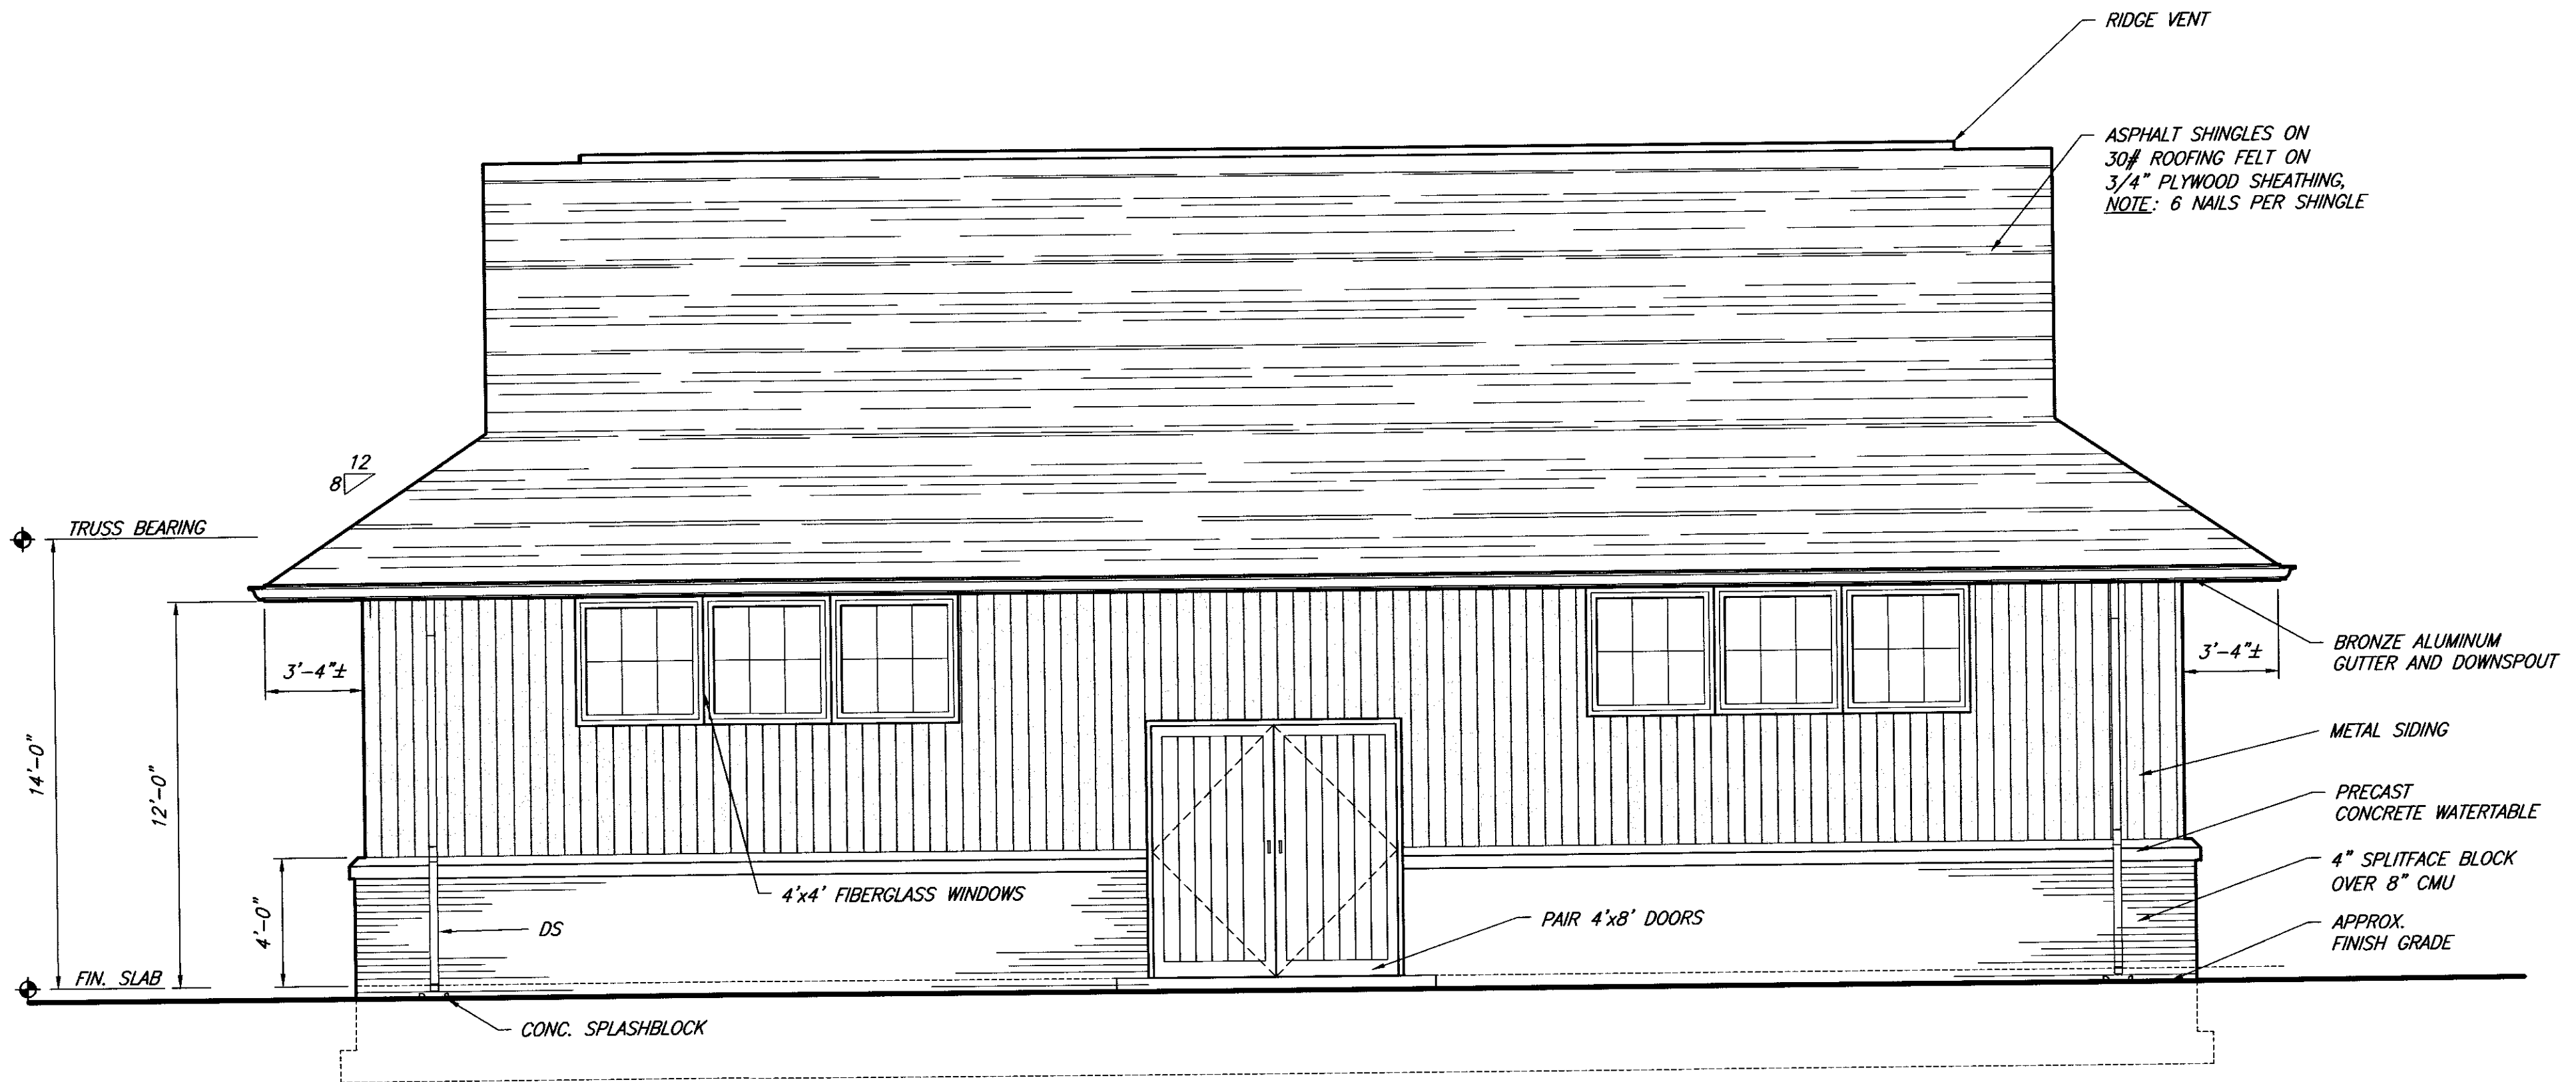

SOUTH ELEVATION (NORTH ELEVATION SIM.)  
 1/4" = 1'-0"

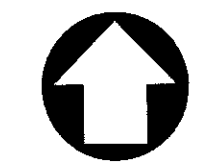

FINAL PLANS  
 PRINTS ISSUED FOR:  
 • CONSTRUCTION PERMIT

NO.	REVISIONS	DATE
1	PER AIDE & COUNTY COMMENTS	4/18/02
2	PER CONTRACTOR COMMENTS	8/12/02
3	PER BUILDING OFFICIAL COMMENTS	8/12/02
4	PER GEOTECH. ENGINEER COMMENTS	10/24/02

THE WATER AND/OR SEWER FACILITIES TO BE CONSTRUCTED IN ACCORDANCE WITH THESE PLANS SHALL BE CONSTRUCTED IN ACCORDANCE WITH THE MARYLAND WATER AND WASTEWATER SERVICES ACT.

THE WATER AND/OR SEWER FACILITIES TO BE CONSTRUCTED IN ACCORDANCE WITH THESE PLANS ARE APPROVED BY WORCESTER COUNTY DEPARTMENT OF PUBLIC WORKS

DIRECTOR  
 W. CO. WATER & WASTEWATER SERVICES


DIRECTOR  
 W. CO. DEPARTMENT OF PUBLIC WORKS

**GMB**  
 GEORGE, MILES & BUHR, LLC  
 ARCHITECTS & ENGINEERS  
 SALISBURY · BALTIMORE · LEWES · SEAFORD · YORK  
 www.gmbnet.com


WATER TREATMENT FACILITIES  
 RIDDLE FARM  
 WORCESTER COUNTY, MARYLAND

ELEVATIONS


SCALE : AS NOTED	SHEET NO.
DESIGN BY : MDM	A-2
DRAWN BY : SG	
CHECKED BY : JAS	
GMB FILE : 2001020-C	
DATE : NOV. 2001	11 16

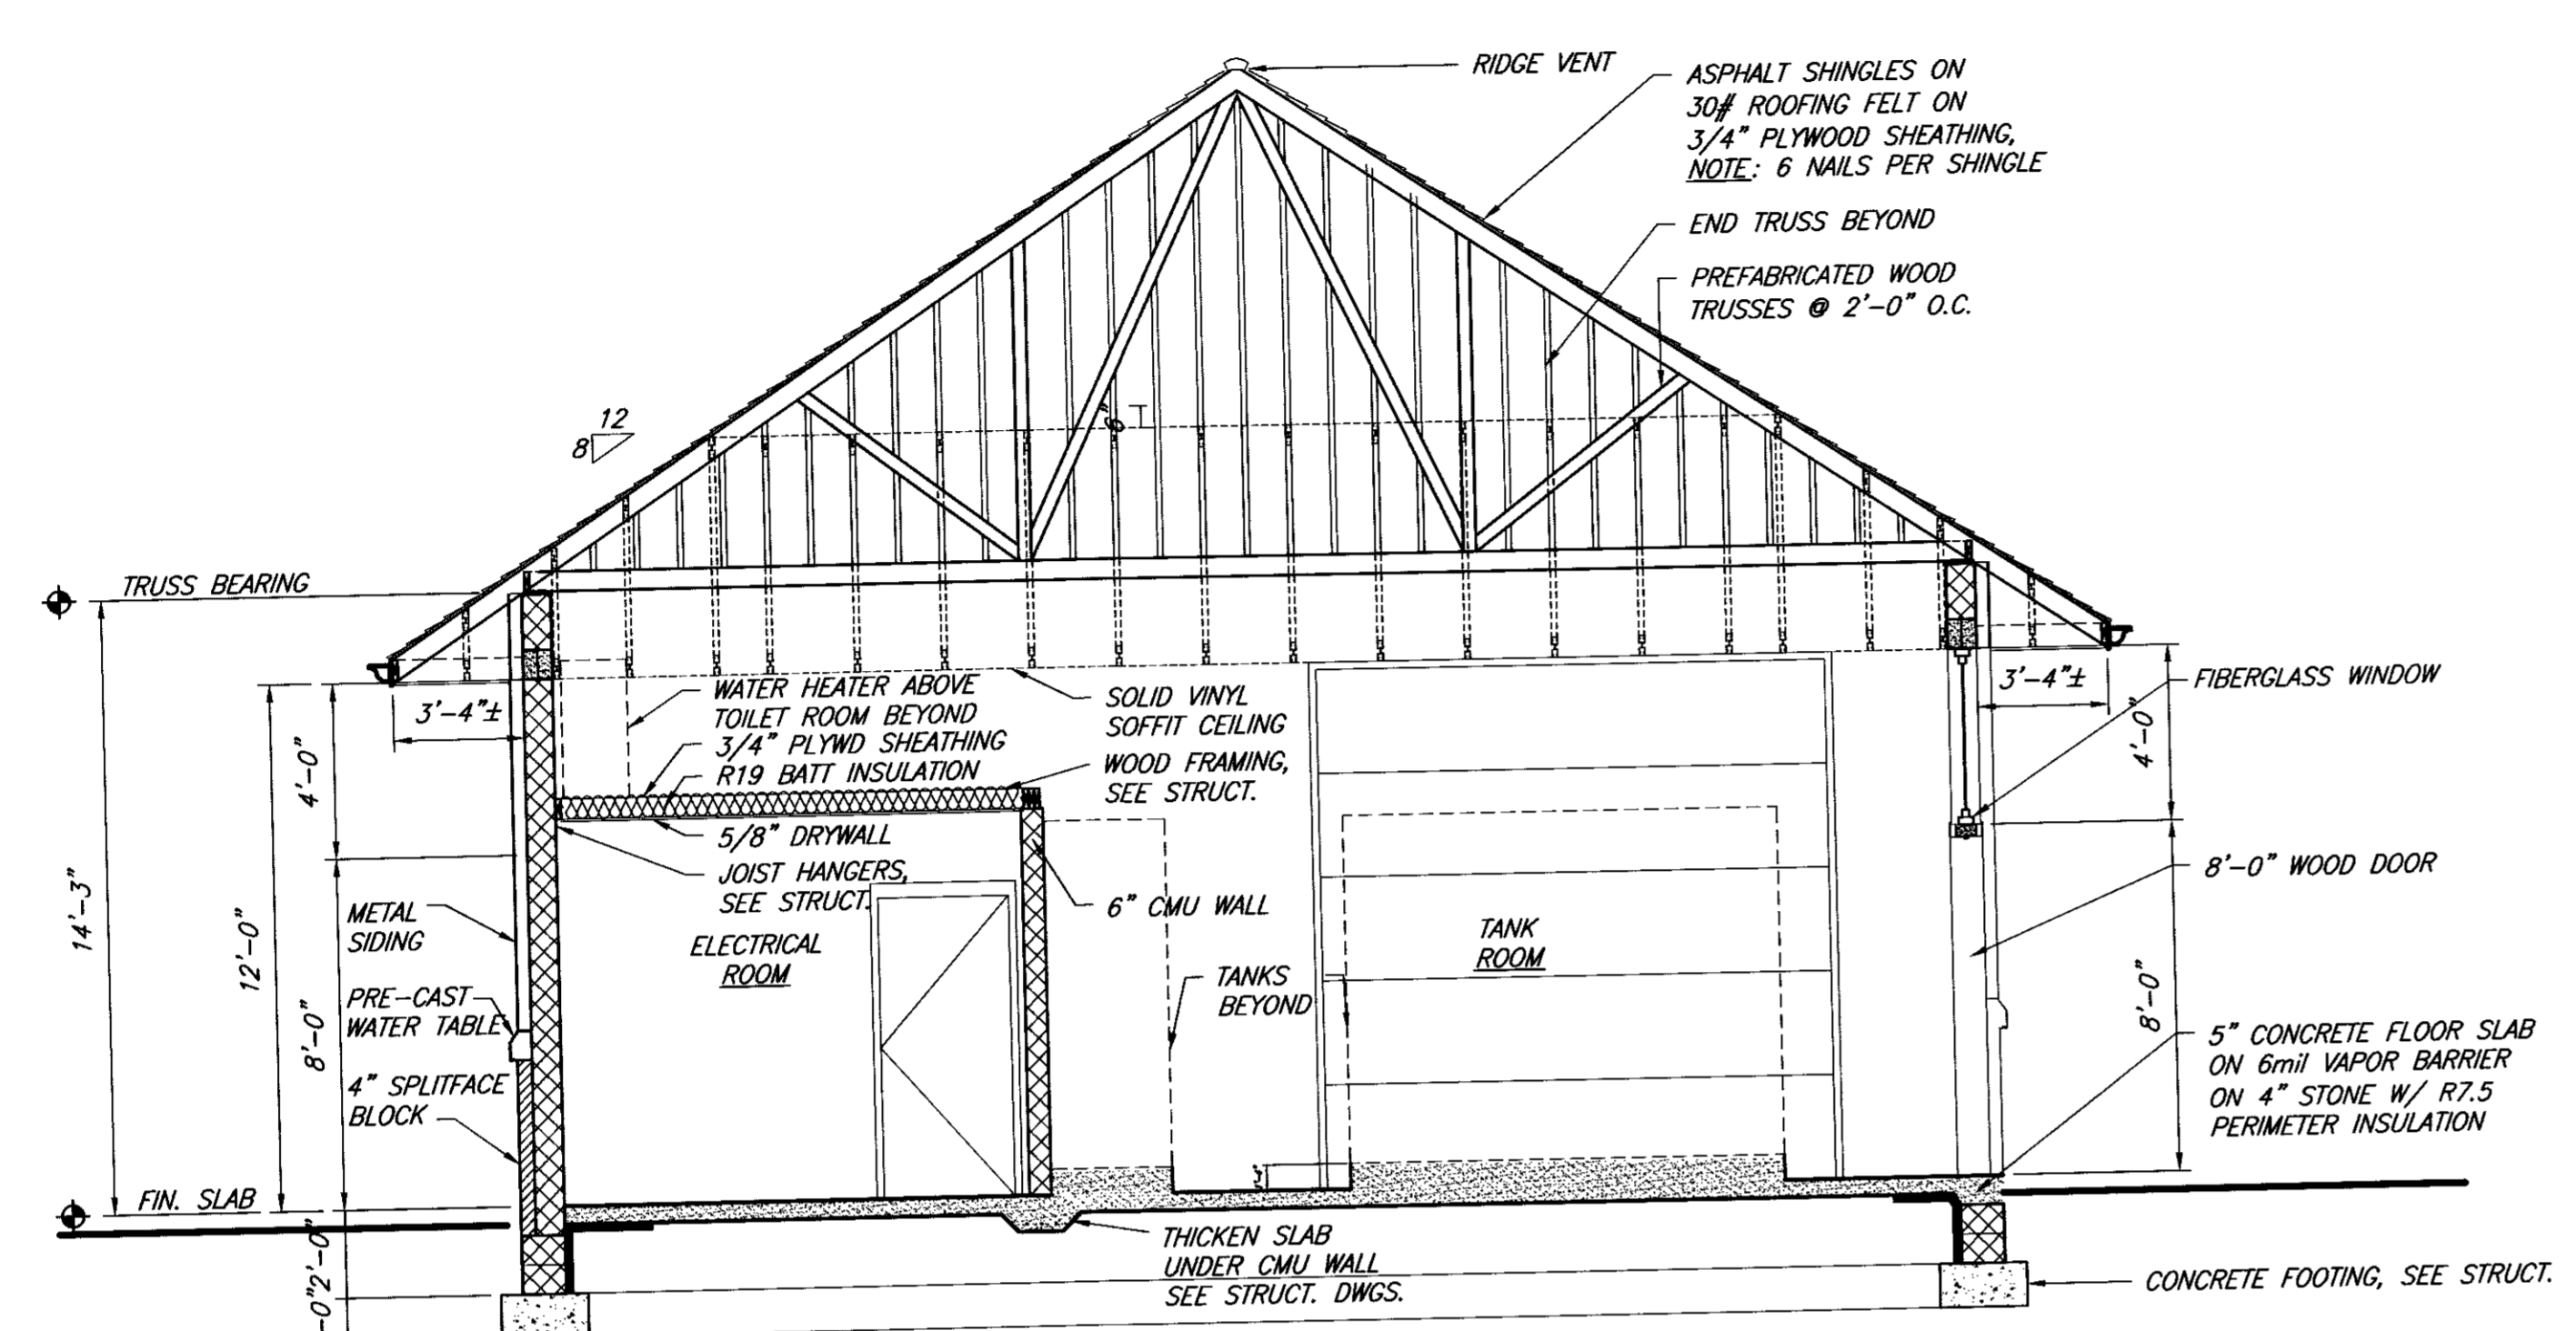

SECTION A-A  
NO SCALE

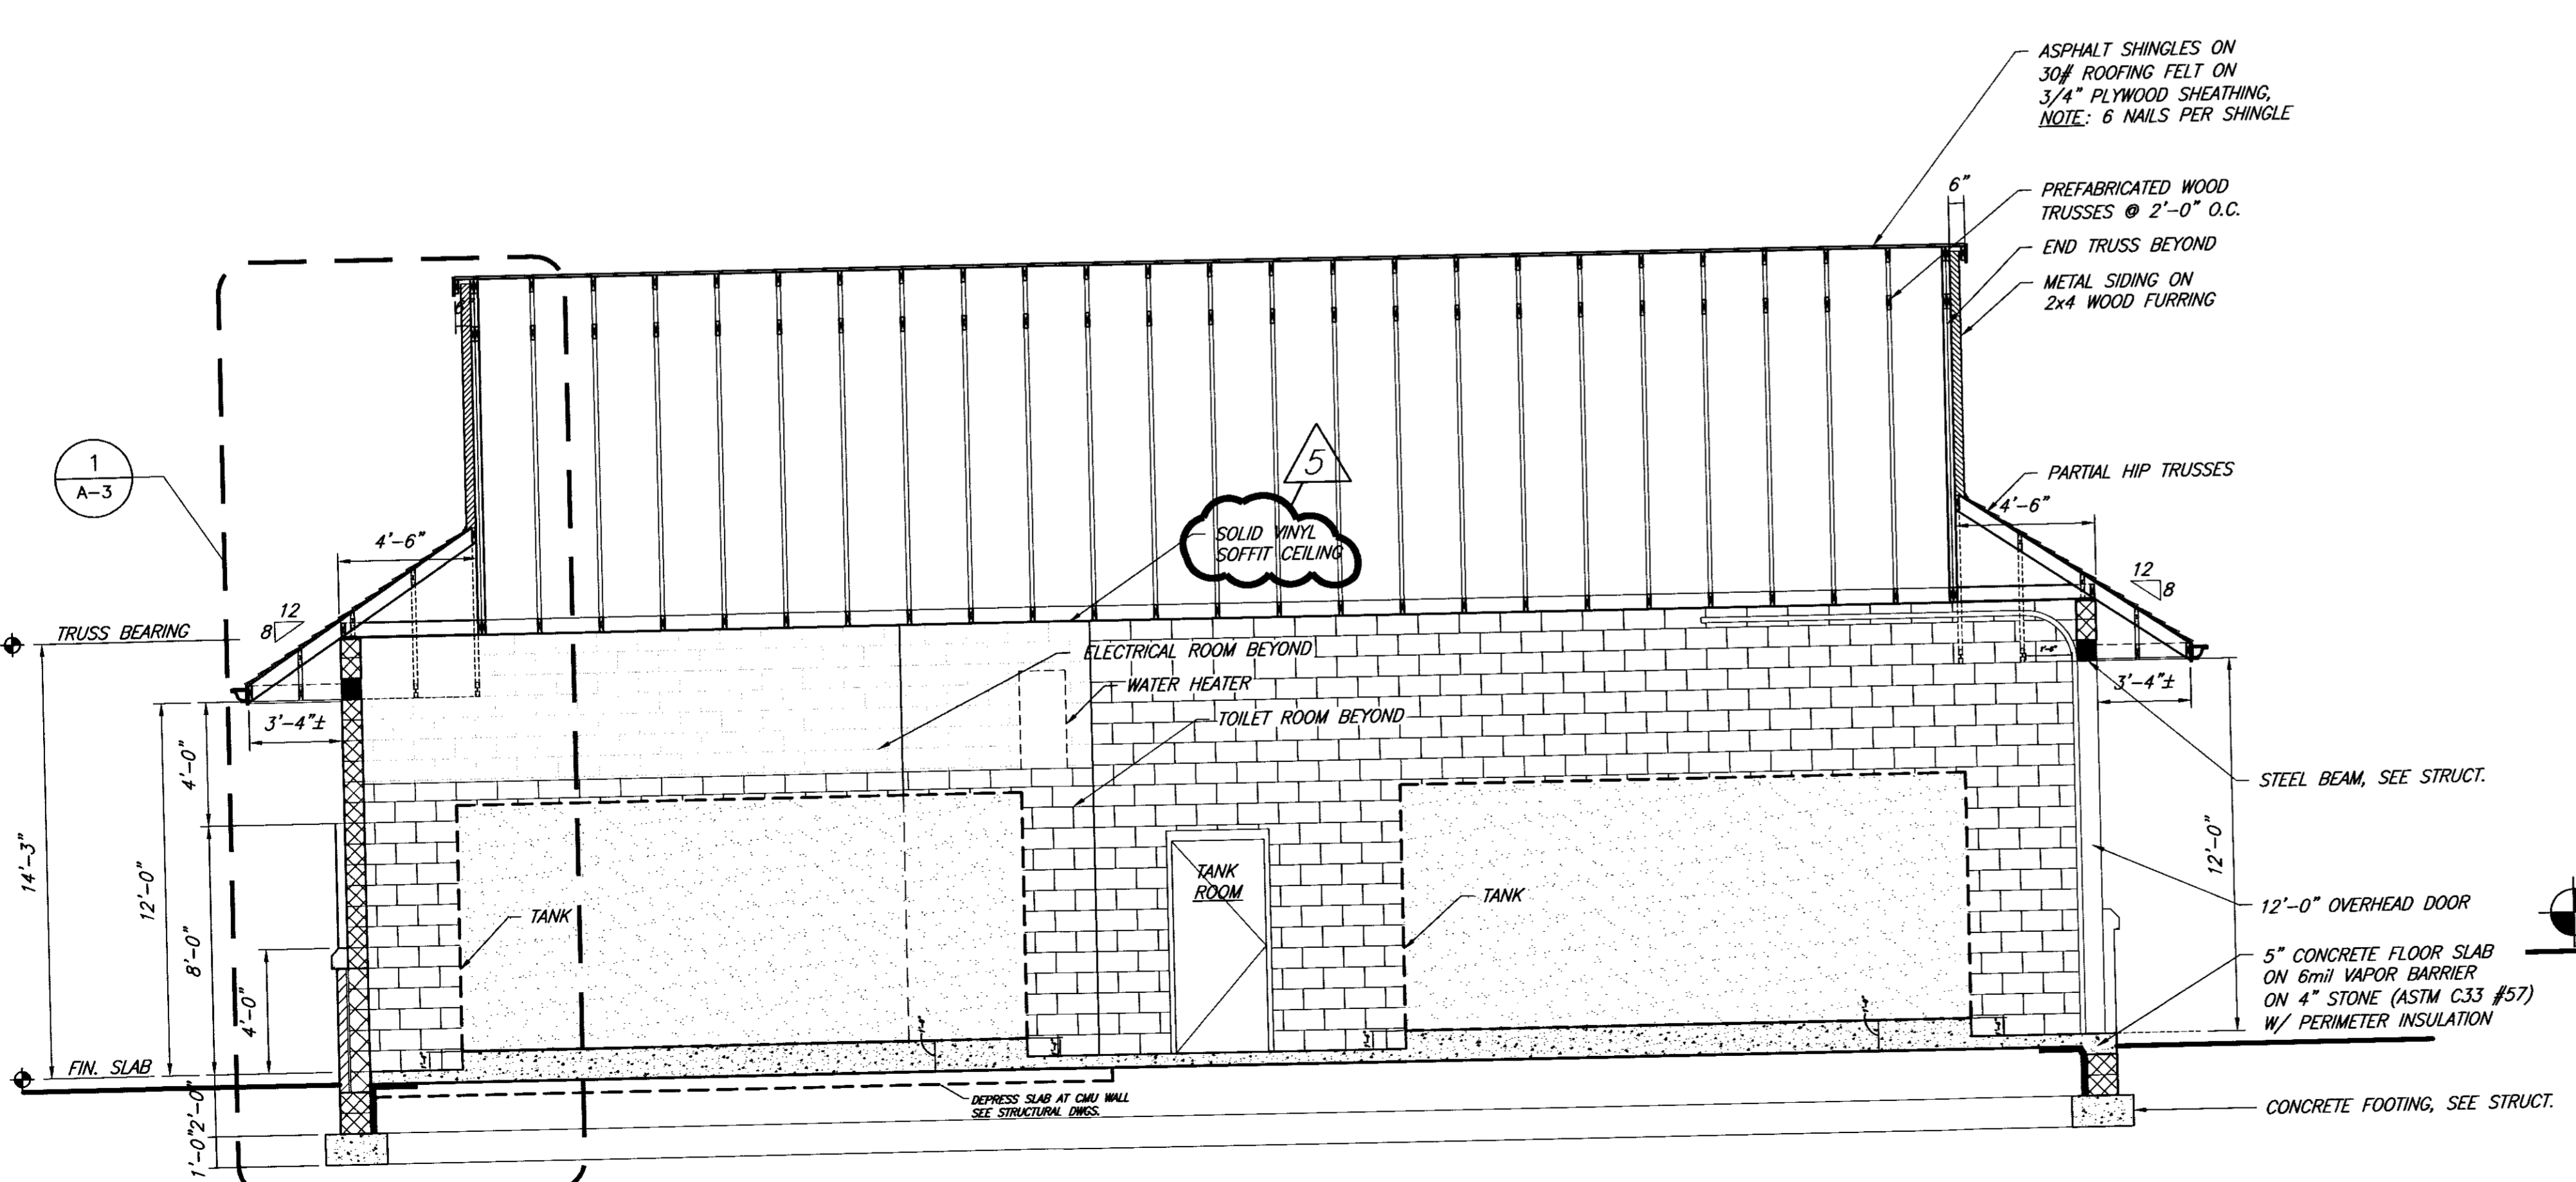

SECTION B-B  
NO SCALE

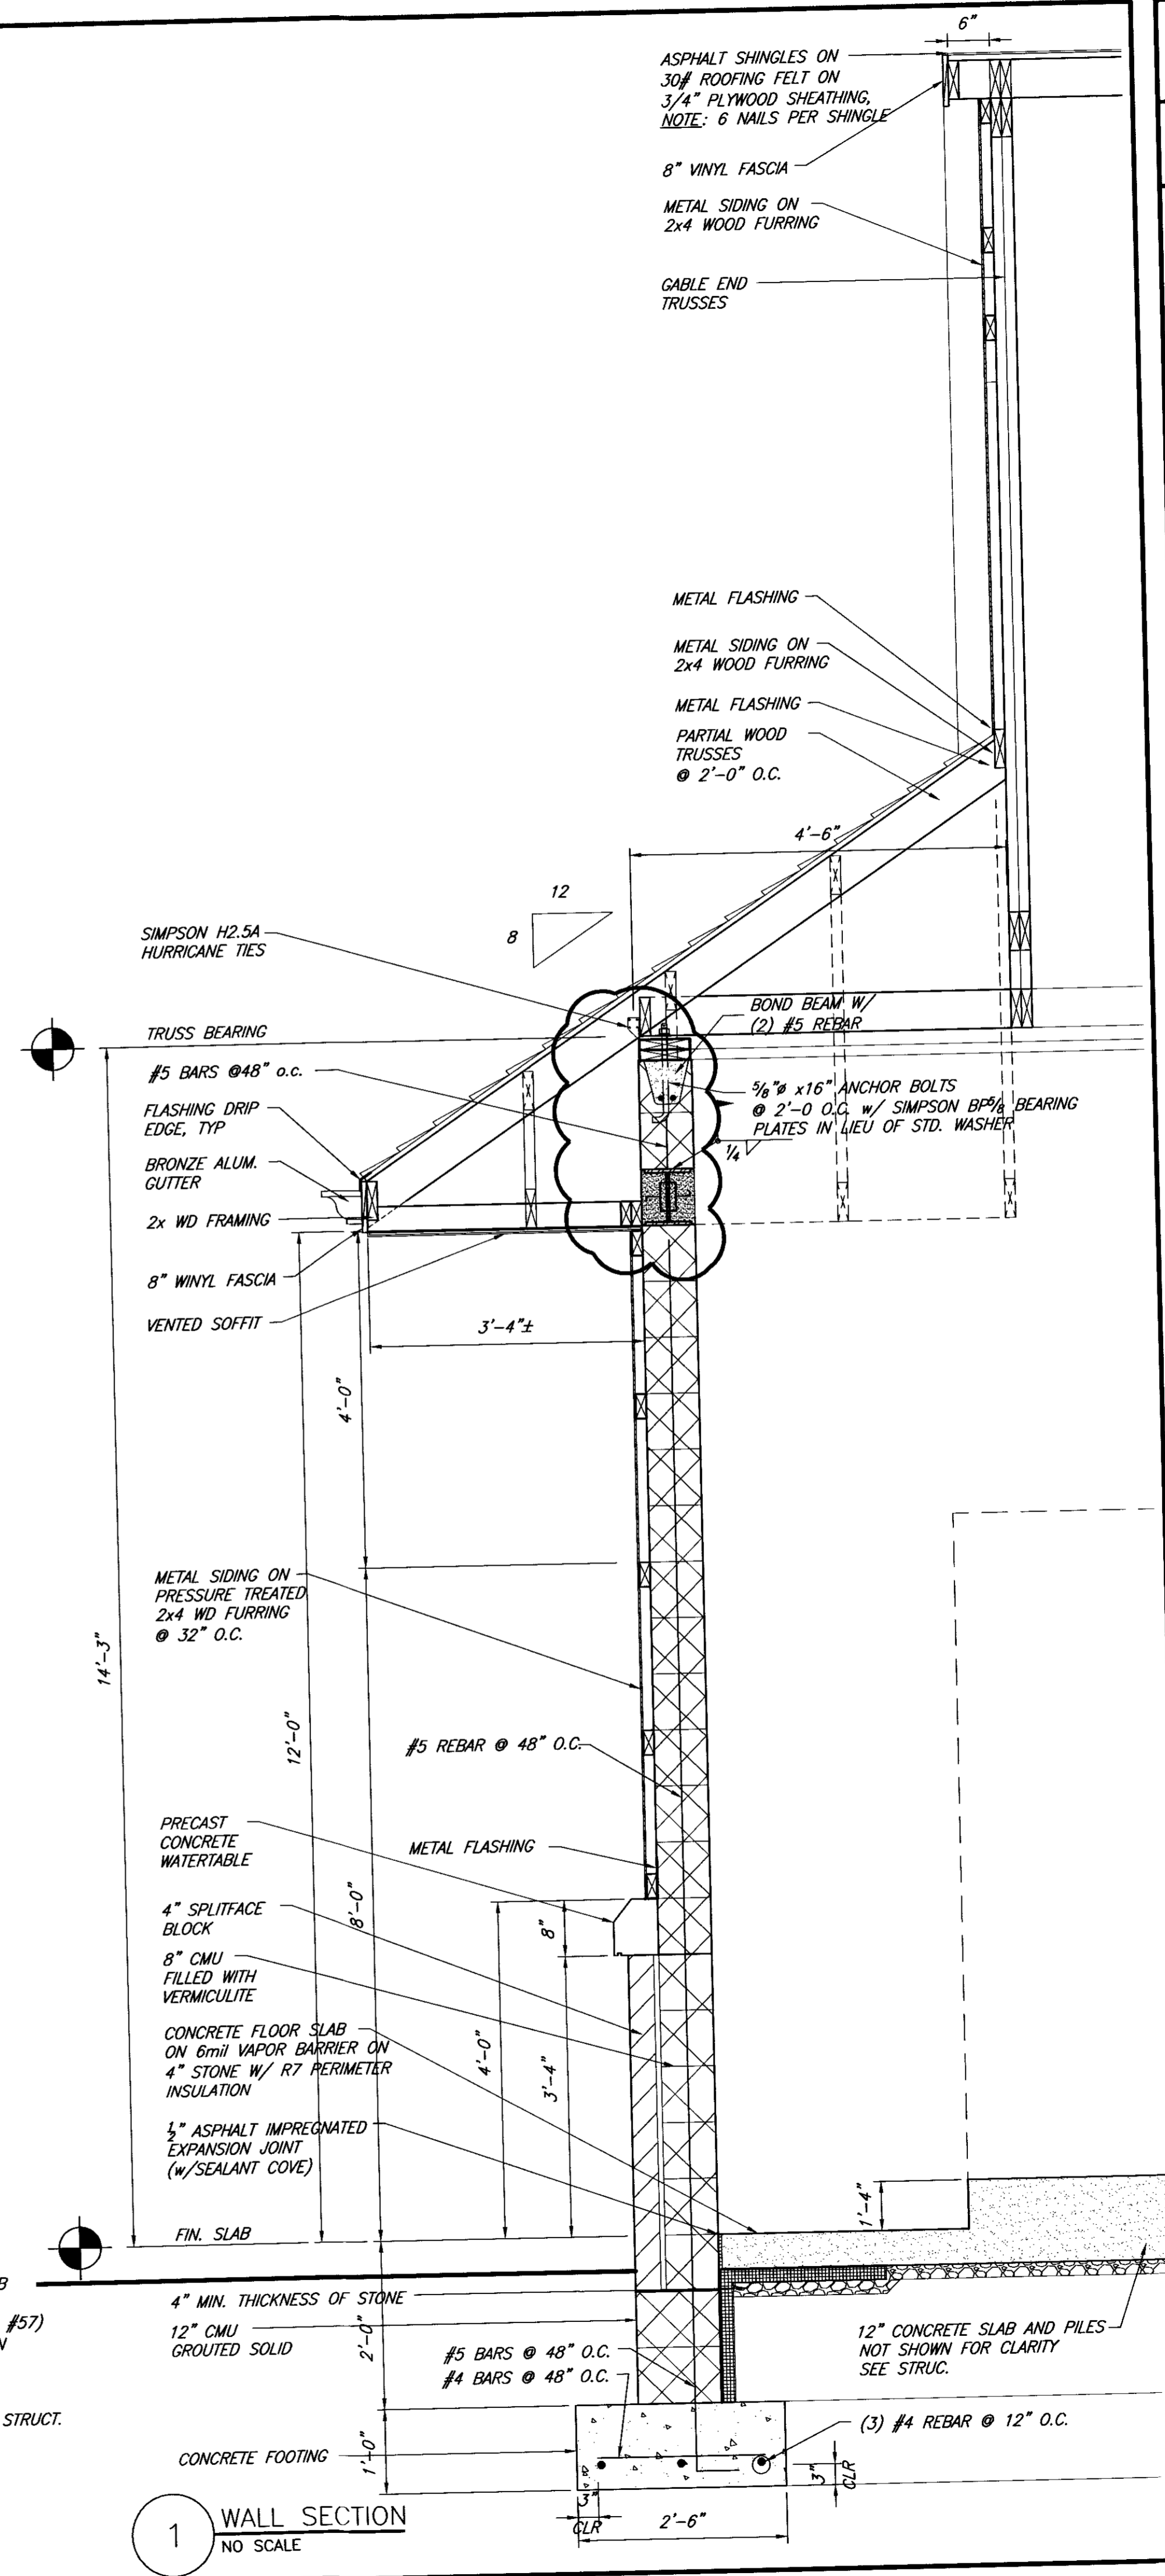

1 WALL SECTION  
NO SCALE

ASPHALT SHINGLES ON  
30# ROOFING FELT ON  
3/4\"/>

METAL FLASHING  
METAL SIDING ON  
2x4 WOOD FURRING  
METAL FLASHING  
PARTIAL WOOD  
TRUSSES  
@ 2'-0\"/>

SIMPSON H2.5A  
HURRICANE TIES  
TRUSS BEARING  
#5 BARS @ 48\"/>

METAL SIDING ON  
PRESSURE TREATED  
2x4 WD FURRING  
@ 32\"/>

CONCRETE FOOTING  
1'-0\"/>

FINAL PLANS PRINTED FOR: CONSTRUCTION PERMIT	
DATE	REVISIONS
4/19/02	PER MDE & COUNTY COMMENTS
8/12/02	PER CONTRACTOR COMMENTS
8/12/02	PER BUILDING OFFICIAL COMMENTS
10/24/02	PER GEOTECH. ENGINEER COMMENTS
11/07/02	PER BUILDING OFFICIAL COMMENTS
NO.	
1	
2	
3	
4	
5	

THE WATER AND/OR SEWER FACILITIES TO BE  
CONSTRUCTED IN ACCORDANCE WITH THESE PLANS  
ARE APPROVED BY WORCESTER COUNTY  
WATER AND WASTEWATER SERVICES

W.D. CO. WATER & WASTEWATER SERVICES  
DIRECTOR

THE WATER AND/OR SEWER FACILITIES TO BE  
CONSTRUCTED IN ACCORDANCE WITH THESE PLANS  
ARE APPROVED BY WORCESTER COUNTY  
ARCHITECTS & ENGINEERS  
DEPARTMENT OF PUBLIC WORKS

W.D. CO. DEPARTMENT OF PUBLIC WORKS  
DIRECTOR

**GMB**  
GEORGE, MILLS & BUHR, LLC  
ARCHITECTS & ENGINEERS  
SALISBURY · BALTIMORE · LEWES · SEAFORD · YORK  
www.gmbnet.com

**WATER TREATMENT FACILITIES  
RIDDLE FARM**

**WORCESTER COUNTY, MARYLAND**

SECTIONS AND DETAILS	
SCALE : AS NOTED	SHEET NO.
DESIGN BY : MDM	
DRAWN BY : SG	
CHECKED BY : JAS	
GMB FILE : 2001020-C	
DATE : NOV. 2001	
	<b>A-3</b>

PRINT-WHITE (100mm)  
FORM-MEDIUM (100mm)  
FORM-BLUE (100mm)  
FORM-RED (100mm)  
FORM-ORANGE (100mm)  
FORM-RED (100mm)  
FORM-ORANGE (100mm)

